



Lat: N 39° 08' 53.994

HARDY COUNTY Department of Health

Tax Map Name _____

Long: W 78° 51' 57.124

**ON-SITE SEWAGE DISPOSAL SYSTEM
INSPECTION REPORT**

Map # _____ Parcel # _____

Name of Owner: JIM M'WILSON Installer: R.W. WILLS

Owner Address: 9565 LAGGERSFIELD CT. VIENNA VA 22181

Property Location: ASHTON WOODS LOT 239

Subdivision: ASHTON WOODS Lot number: 239

Type of Facility: NEW HOME Facility is: New Existing Lot Size (ft²/acres): 20⁺

Design Loading: Bedrooms: 2 or GPD: _____ Water Supply: Existing Proposed Type: WELL

System requires a perpetual maintenance program as per §64CSR9.7.2: Yes No

SEWAGE TANK COMPONENTS

	Septic Tank 1:	Septic Tank 2:	Pump Chamber:		Septic Tank 1:	Septic Tank 2:	Pump Chamber:
Capacity in Gallons:	<u>1000</u>			Distance to dwelling:	<u>29'</u>		
Constructed of:	<u>PLASTIC</u>			Distance to water	Line: <u>50'</u>		
					Source: <u>50'</u>		
Manufacturer:	<u>NORTHWESTCO</u>			Distance to property line:	<u>50'</u>		
4" inspection port, or riser to surface?	Riser <input checked="" type="checkbox"/> Port <input type="checkbox"/>	Riser <input type="checkbox"/> Port <input type="checkbox"/>	Riser <input type="checkbox"/>	Effluent filter?	Yes <input checked="" type="checkbox"/> No <input type="checkbox"/>	Yes <input type="checkbox"/> No <input type="checkbox"/>	

ABSORPTION FIELD

Class I System: Chamber Eljen Gravelless Pipe: Gravel Media Trenches Other _____

Manufacturer _____ Square footage Permitted 1200 ft² Installed 840 ft²

Number of lines: 3 Trench width: 18-36 inches

Lengths of lines: 80, 80, 80

Inspection ports installed? Yes No Distribution box used? Yes No Outlets level? Yes No

If chambers, length of each section: _____ Gravelless pipe diameter: _____

If bed configuration used, dimensions: _____ X _____ Maximum depth to bed bottom on upslope side: _____

Distance of absorption field to Dwelling: 39, Water Supply: 100', Water Line: _____, Property Line: _____

Drainfield laterals installed on-contour: Yes No Average Depth: 24 Maximum depth: 36

Class II System: Design type _____

Remarks: _____

840 sq ft INSTALLED
1200 Permitted

840 is Fine For 2 BDEM on this site


System is installed as per the permitted design and layout. Yes No ↗

Include sketch of installation on reverse.

Sketch of Installation with Triangulation or Distance to Specific Landmarks.
Include reserve area boundaries.

LEGEND:

- | | | | |
|---|---|--|---|
|  House/Facility |  Property Line |  Fence North |  Pump Tank |
|  Soil Absorption Line |  Single Wide Manufactured Home |  Stream Flow |  Septic Tank |
|  Existing Water Supply |  Distribution Box |  Wooded Area Boundary | |
|  Proposed Water Supply |  Drain Field Inspection Port | | |

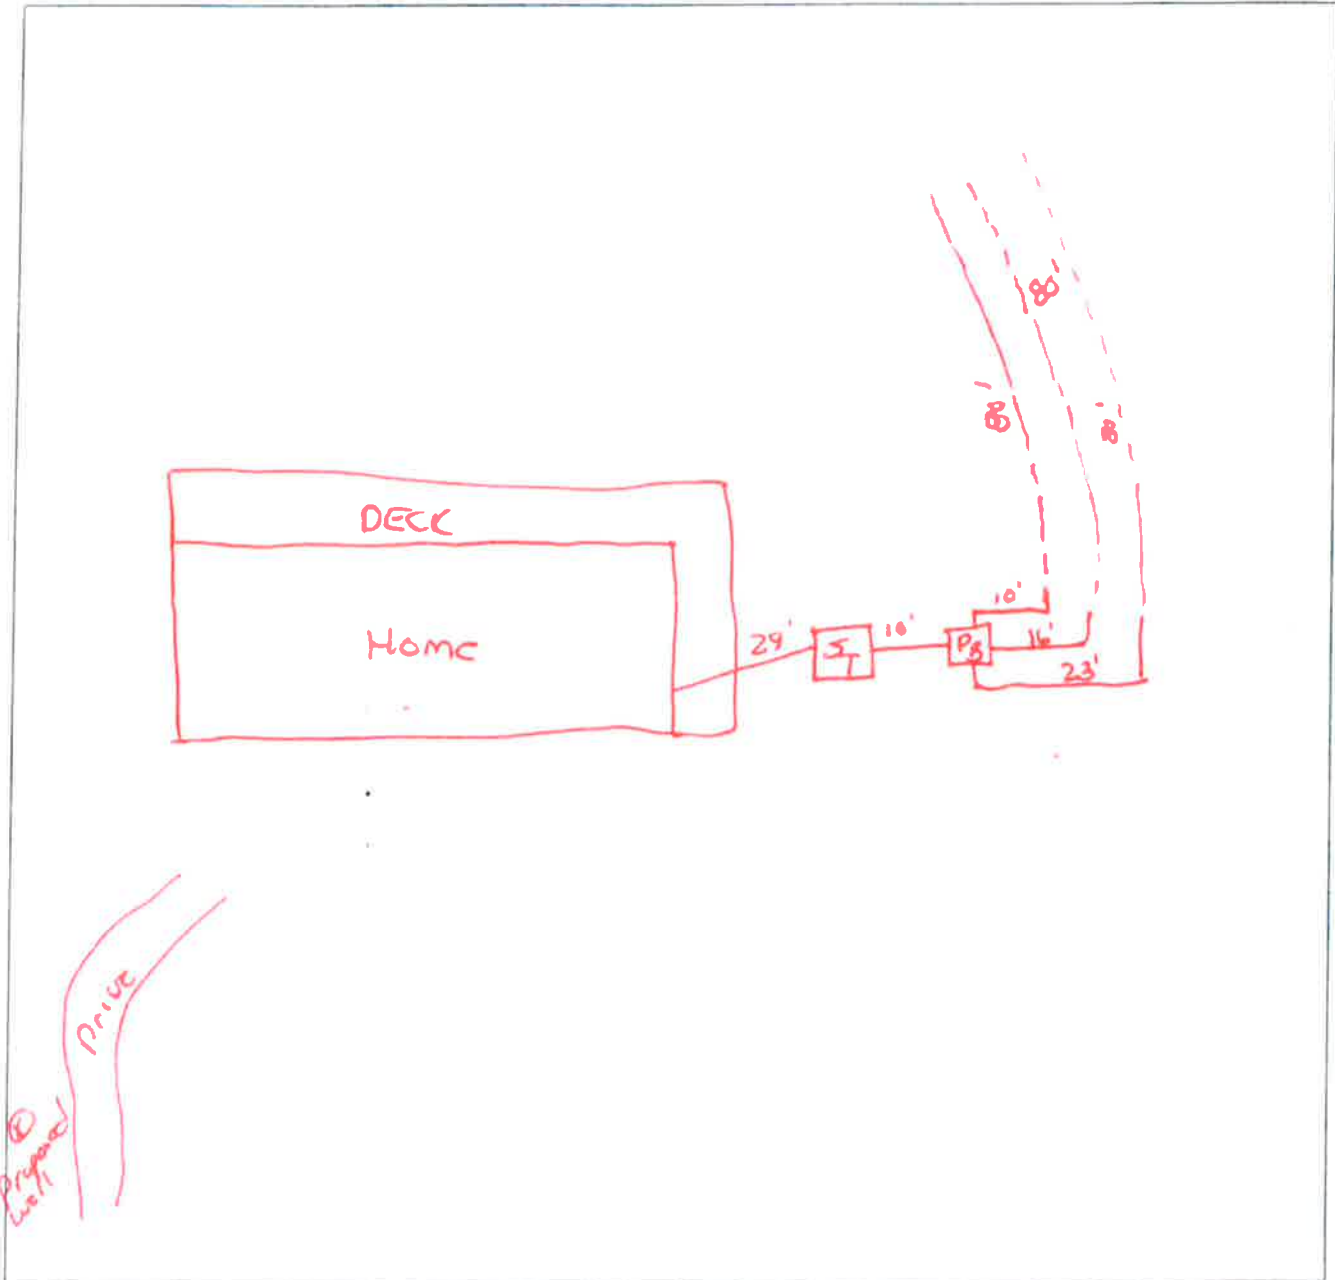

System is: Approved System is NOT Approved:

COMMENTS:

Dates visited:

Will Duns
Sanitarian

7-22-13
Date Final Inspection